

ADDENDUM TWO

Addendum Two (AD.02) to the drawings and specifications prepared by Gibraltar Design for **Maconaquah HS – Piping Replacement & Related Work** for Porter Township School Corporation, Valparaiso, Indiana.

All Contractors bidding on this project shall read all of the items covered below and shall comply with all of the requirements as set forth, including any necessary refinements or additions generated by this Addendum and required by the intent of the original contract documents. All Contractors shall acknowledge on their bid form that they have received Addendum One, and this Addendum and include the appropriate content of same within their bid proposal.

GENERAL

1. Questions

- A. **Question:** Who is the temperature control manufacturer at the school?

Answer: Trane, local branch office. All costs associated with the pressure sensors and installation of the sensors shall be included in the base bid.

- B. **Question:** Unit Price 2 includes hot water piping mains and branches, and insulation wrap. On the drawings, it doesn't appear that the hydronic heating piping is being replaced. Please clarify?

Answer: Hydronic heating piping is not being replaced under base bid. The unit price is being requested in case it is discovered that a section of heating piping needs replacement.

- C. **Question:** We are to insulate the heating hot water lines, and all domestic water lines in the tunnel. Are these lines currently insulated?

Answer: The hot water heating and domestic piping systems will not be insulated when construction begins.

SPECIFICATIONS

2. Section 01 21 00

Allowances

- A. Add new Paragraph 1.3.B. as follows:

“B. Tunnel Decking Repair Allowance: Contractor is to provide metal and fastener repairs as dictated by field conditions in the Tunnels so as to repair decking delamination conditions. Contractor is to provide proposed repairs and itemized costs of labor and material to be applied toward Allowance; allow the lump sum of Ten Thousand Dollars and No Cents (\$10,000).”

DRAWINGS

3. Sheet MD101

- A. Changed existing chilled water supply/return piping from 6" to 8" pipe. Also showed an existing tap location.

4. Sheet M-102

- A. Changed chilled water supply/return piping from 6" to 8" pipe. Also showed an existing tap location.

Page 1 through 2, inclusive, and Two (2) Full-Size Drawings, constitute the total makeup of **Addendum Two**.



Y:\25-190 Maconaquah HS - Piping Improvements\Specs\AD02\25-190 - MSC - AD02.doc

SHEET NOTES


1. REMOVE CHILLED WATER SUPPLY AND RETURN PIPING COMPLETE AS REQUIRED.



GIBRALTAR DESIGN
ARCHITECTURE • ENGINEERING • INTERIOR DESIGN



PROJECT:
MACONAQUAH HIGH SCHOOL PIPING REPLACEMENT AND RELATED WORK
Maconaquah School Corporation
200 E 800 S
BUNKER HILL, INDIANA, 46914

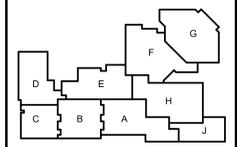


KEY PLAN

100% SET 01/23/2026

GIBRALTAR DESIGN

9102 N. Meridian St., Ste. 300
Indianapolis, IN 46260
Homepage: www.GibraltarDesign.com
Email: info@GibraltarDesign.com
Phone 317.580.5777 Fax 317.580.5778

PROJECT
25-190
DATE
01/23/2026
COORDINATED BY
JC
DRAWN BY
AD
CHECKED BY
DJ

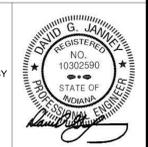

COPYRIGHT NOTICE:
THE CONCEPTS, DESIGNS, PLANS, DETAILS, ETC. SHOWN ON THIS DOCUMENT ARE THE PROPERTY OF GIBRALTAR DESIGN AND WERE CREATED FOR USE ON THIS SPECIFIC PROJECT. NONE OF THIS INFORMATION SHALL BE USED BY ANY PERSON OR FIRM FOR ANY PURPOSE WITHOUT THE EXPRESS WRITTEN CONSENT OF GIBRALTAR DESIGN. THE OWNER MAY RETURN COPIES FOR INFORMATION AND REFERENCE IN CONNECTION ONLY WITH THIS PROJECT.


REVISIONS

MARK	DATE	ISSUED FOR
AD-2	2/13/2026	ADDENDUM NO. 2

DRAWING
MECHANICAL DEMOLITION TUNNEL PLAN

PROJECT
MACONAQUAH HIGH SCHOOL PIPING REPLACEMENT AND RELATED WORK

GIBRALTAR DESIGN SHEET
MD101

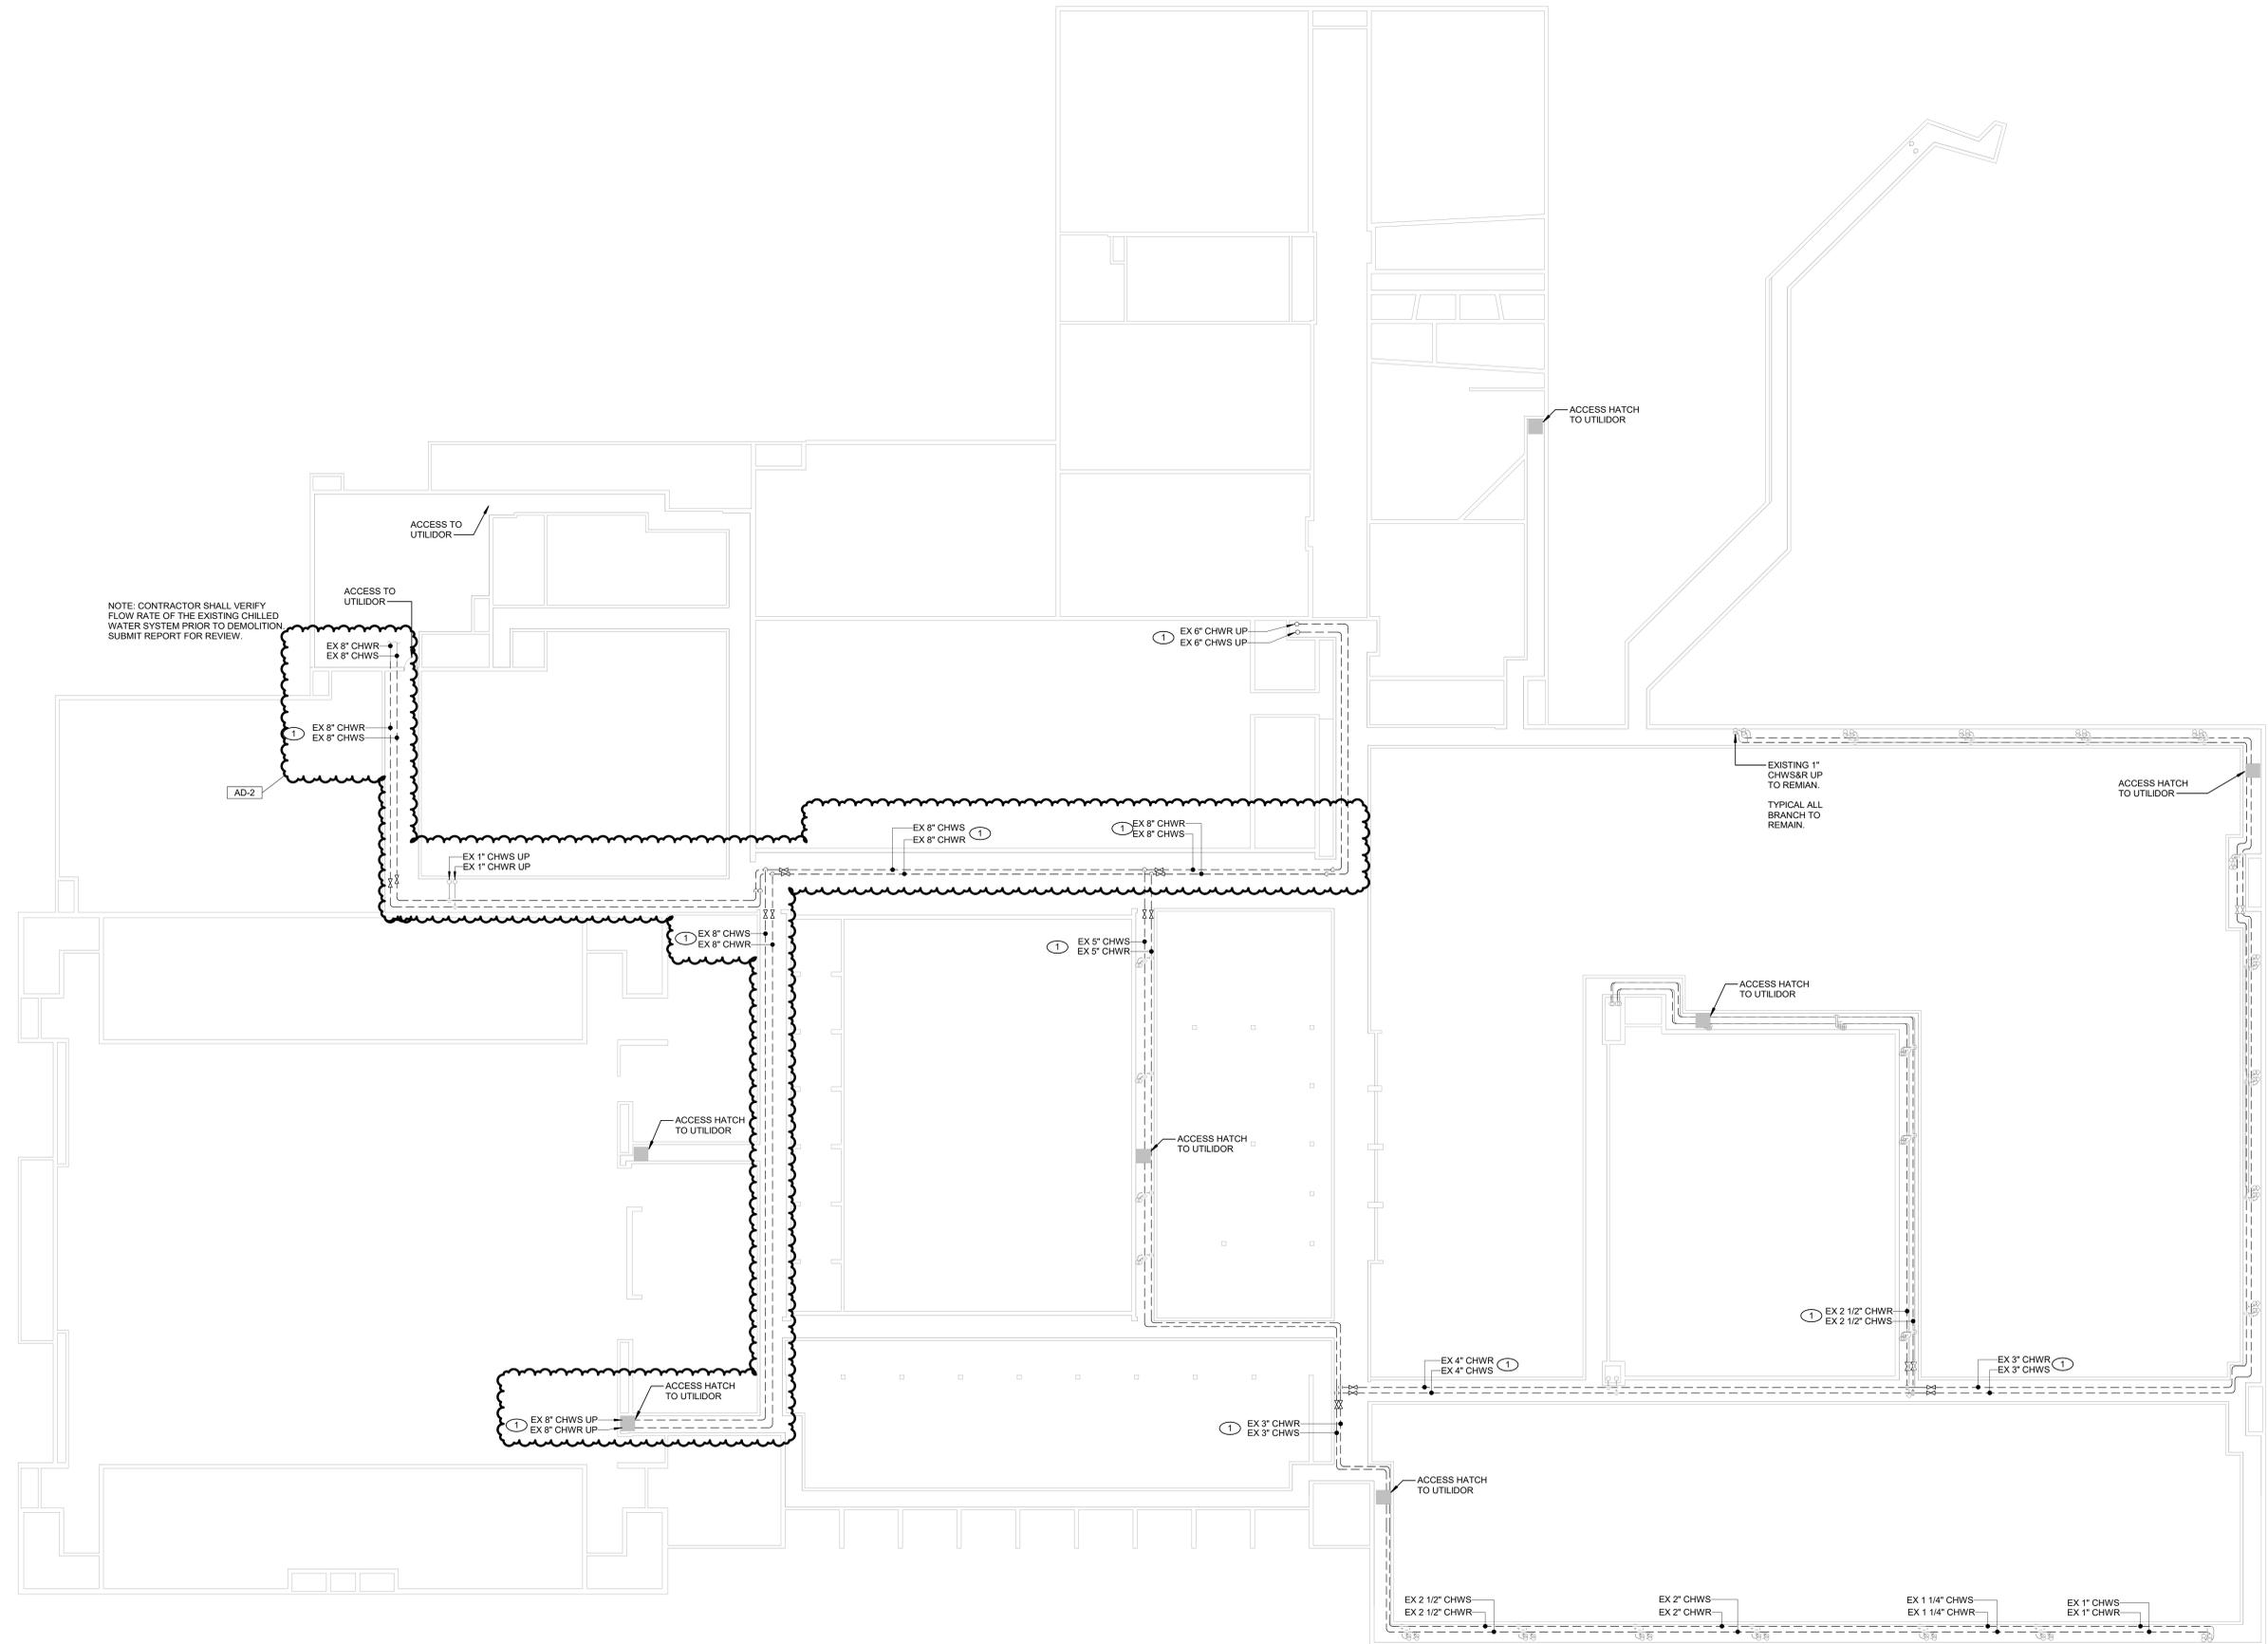

NOTE: CONTRACTOR SHALL VERIFY FLOW RATE OF THE EXISTING CHILLED WATER SYSTEM PRIOR TO DEMOLITION. SUBMIT REPORT FOR REVIEW.

MECHANICAL DEMOLITION TUNNEL PLAN
SCALE: 1/16" = 1'-0"



SHEET NOTES


1. NEW CHILLED WATER SUPPLY AND RETURN PIPING. PROVIDE NEW PIPING SUPPORTS AS REQUIRED FOR INSTALLATION.



GIBRALTAR DESIGN
ARCHITECTURE • ENGINEERING • INTERIOR DESIGN



PROJECT:
MACONAQUAH HIGH SCHOOL PIPING REPLACEMENT AND RELATED WORK
Maconaquah School Corporation
200 E 800 S
BUNKER HILL, INDIANA, 46914

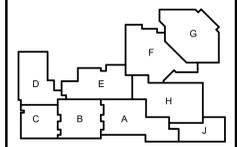

KEY PLAN
100% SET 01/23/2026

GIBRALTAR DESIGN
9102 N. Meridian St., Ste. 300
Indianapolis, IN 46260
Homepage: www.GibraltarDesign.com
Email: info@GibraltarDesign.com
Phone 317.580.5777 Fax 317.580.5778

PROJECT: 25-190
DATE: 01/23/2026
COORDINATED BY: JC
DRAWN BY: AD
CHECKED BY: DJ




COPYRIGHT NOTICE:
THE CONCEPTS, DESIGN PLANS, DETAILS, ETC. SHOWN ON THIS DOCUMENT ARE THE PROPERTY OF GIBRALTAR DESIGN AND WERE CREATED FOR USE ON THIS SPECIFIC PROJECT. NONE OF THIS INFORMATION SHALL BE USED BY ANY PERSON OR FIRM FOR ANY PURPOSE WITHOUT THE EXPRESS WRITTEN CONSENT OF GIBRALTAR DESIGN. THE OWNER MAY RETURN COPIES FOR INFORMATION AND REFERENCE IN CONNECTION ONLY WITH THIS PROJECT.

REVISIONS

MARK	DATE	ISSUED FOR
AD-2	2/13/2026	ADDENDUM NO. 2

DRAWING: MECHANICAL CHILLED WATER PIPING TUNNEL PLAN
PROJECT: MACONAQUAH HIGH SCHOOL PIPING REPLACEMENT AND RELATED WORK

SHEET: M-102

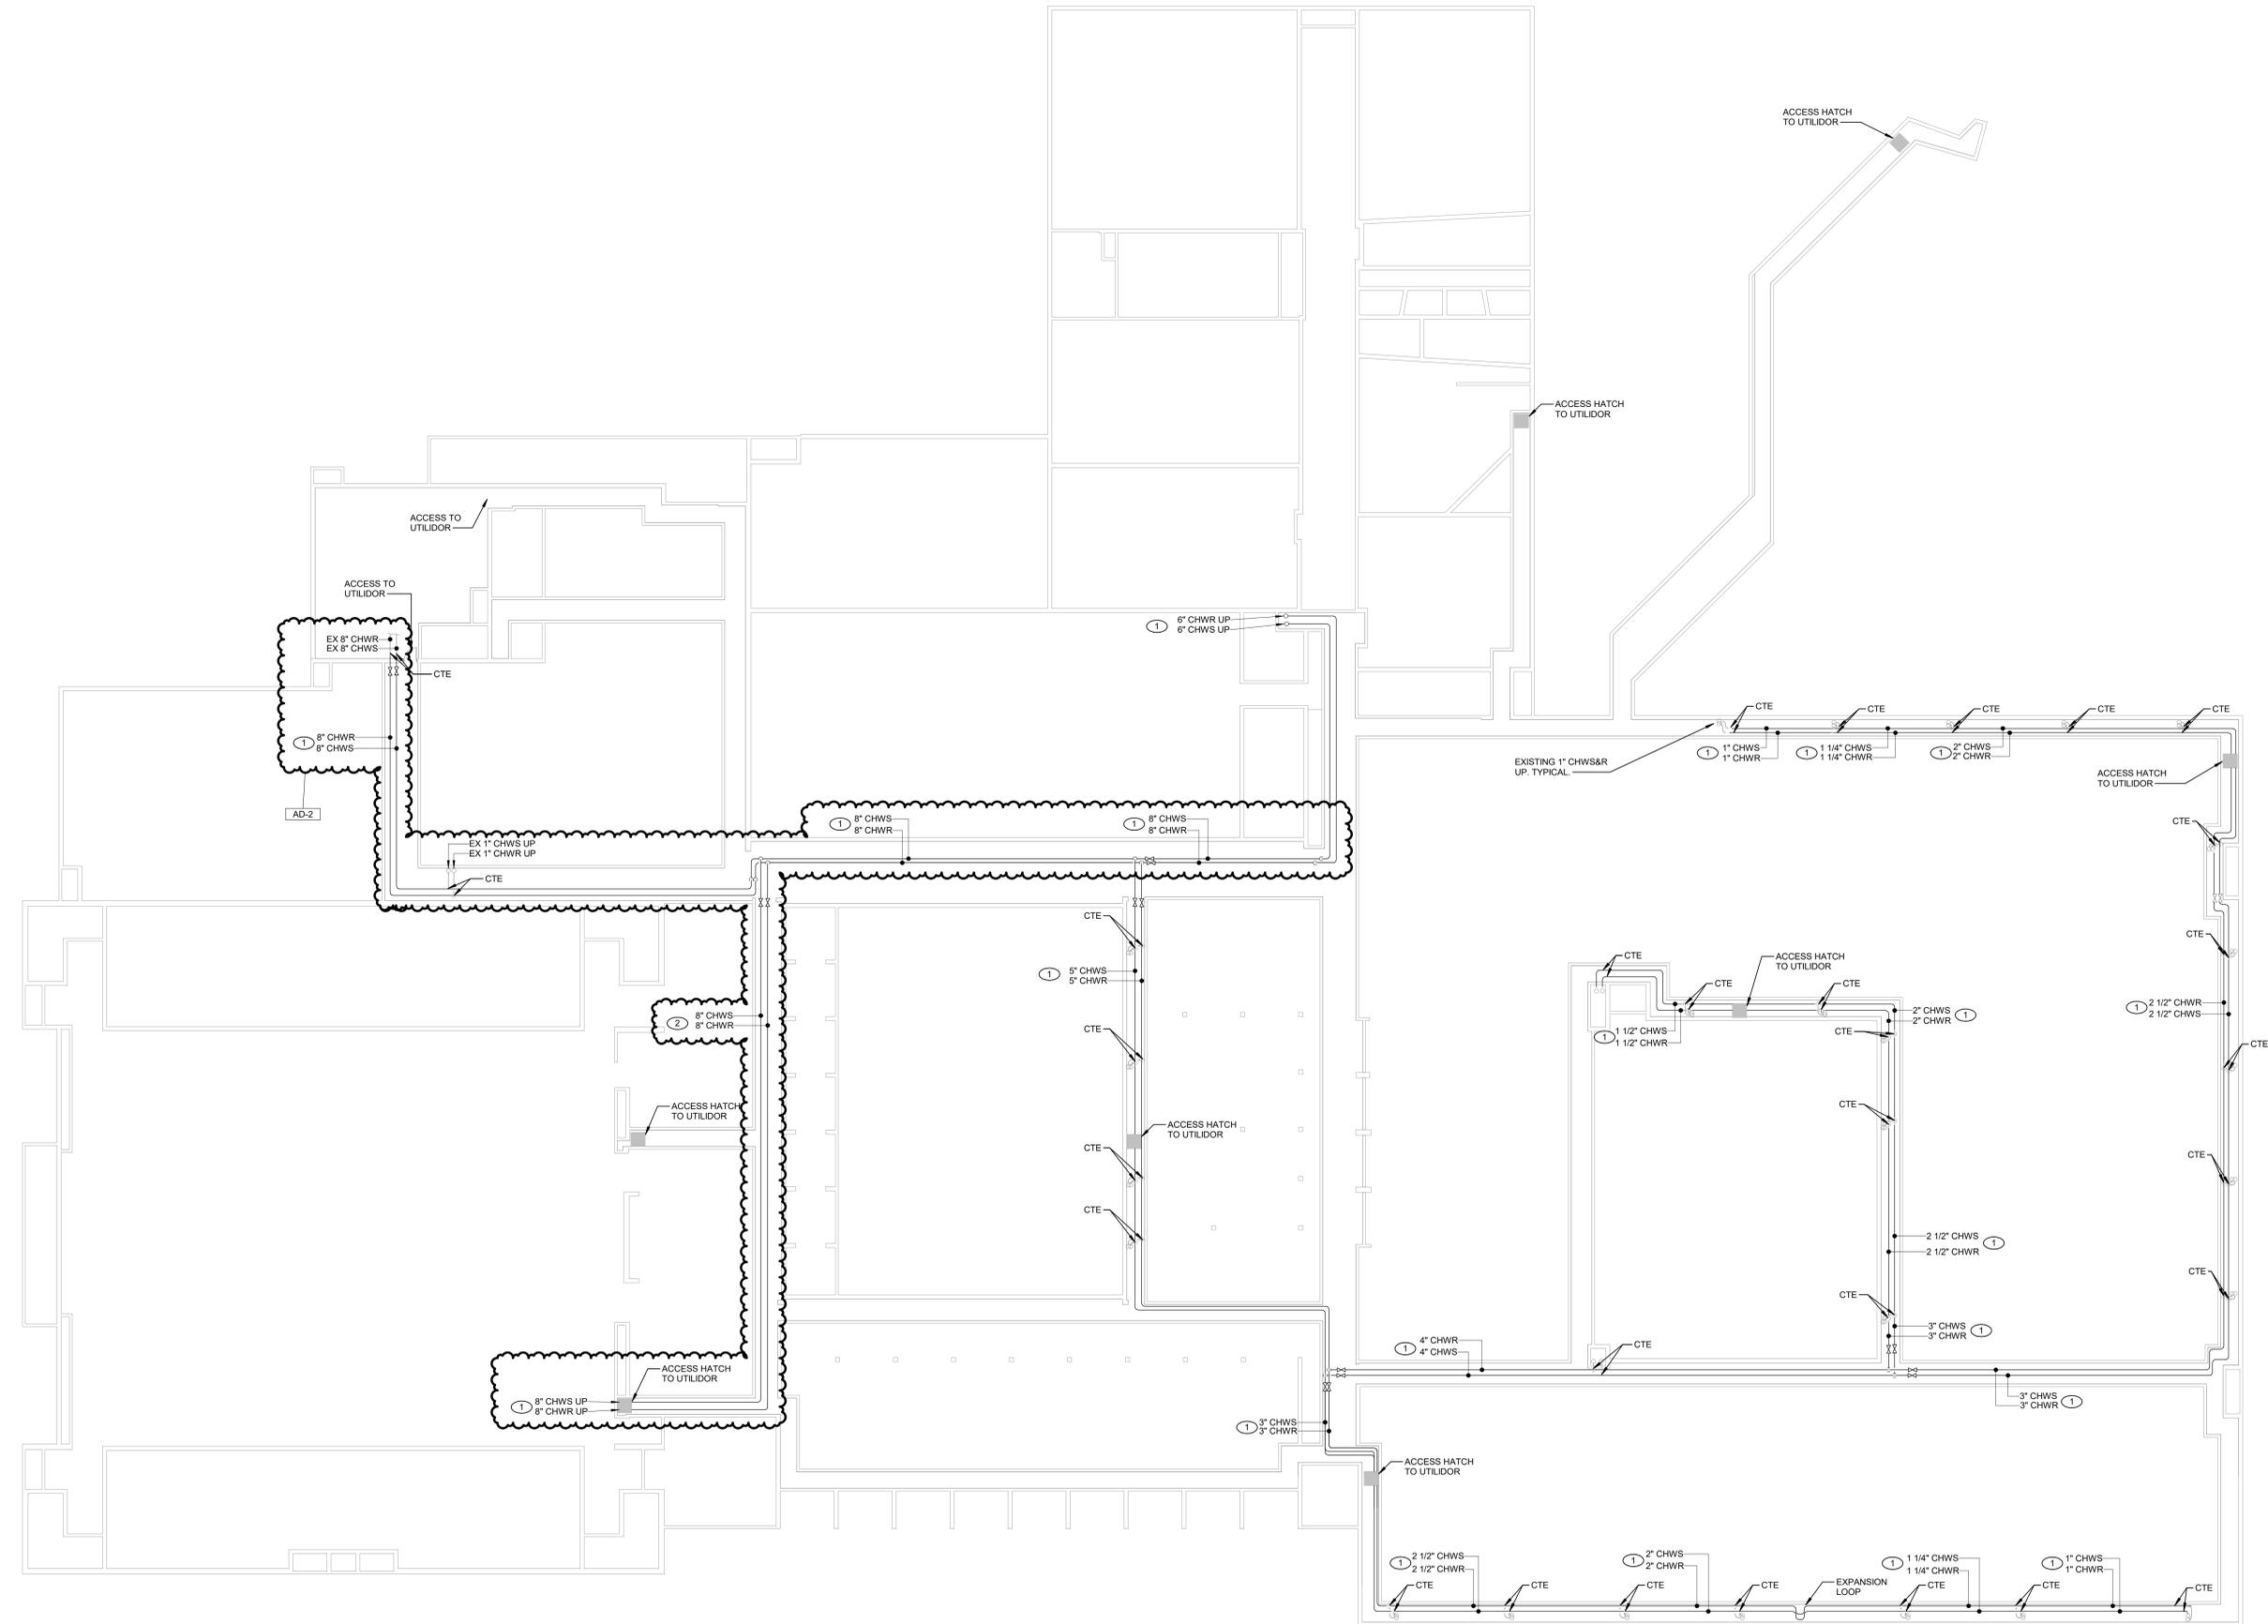

MECHANICAL CHILLED WATER PIPING TUNNEL PLAN
SCALE: 1/16" = 1'-0"

2/13/2026 12:25:45 PM C:\Users\adylan\Documents\MEG_Maconaquah_HS_MP_R25_meg_cad7.rvt